

REVISIONS

REV.	ECN	DESCRIPTION	DATE	APPROVED
X6		NOTE 6 CABLE SIZE CHANGED TO 350MCM	11/15/2018	YMG
X7		ADD FR REDLINE NOTES	08/20/2019	YMG

NOTES: UNLESS OTHERWISE SPECIFIED

1. ALL DIMENSIONS IN BRACKETS ARE IN MM.
2. ROUTINE MAINTENANCE IS FRONT AND REAR ACCESS.
3. ALL OPERATOR CONTROLS ARE FRONT FACING WITHOUT EXPOSURE TO LIVE PARTS.
4. MINIMUM CLEARANCE PER ELECTRICAL CODE.
5. APPROXIMATE WEIGHT: 1300 LBS. (590 KG).
6. INPUT CABLE SIZE (1) 350MCM CU PER PHASE.
7. EYEBOARDS ARE REMOVABLE AFTER UNIT PLACEMENT.


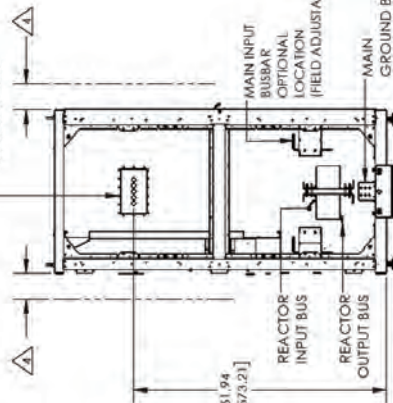


TABLE 1.0

SKU#	SWITCH TYPE	BREAKER TYPE	HMI TYPE
15200001-SQD	SQ D	P/N LGI46000540X	SQ D P/N LGI46250C131TX
15200001-ETN	EATON	P/N LGI46250C131TX	EATON P/N JGH425033GCG
15200001-SQD-PM	SQ D	P/N LGI46000540X	SQ D P/N LGI46250C131TX

THE DRAWING CONTAINS
CONFIDENTIAL & PROPRIETARY
INFORMATION. IT IS NOT
TO BE REPRODUCED, COPIED,
OR DISCLOSED IN ANY MANNER
WITHOUT THE EXPRESSED
WRITTEN PERMISSION OF
POWER DISTRIBUTION, INC.

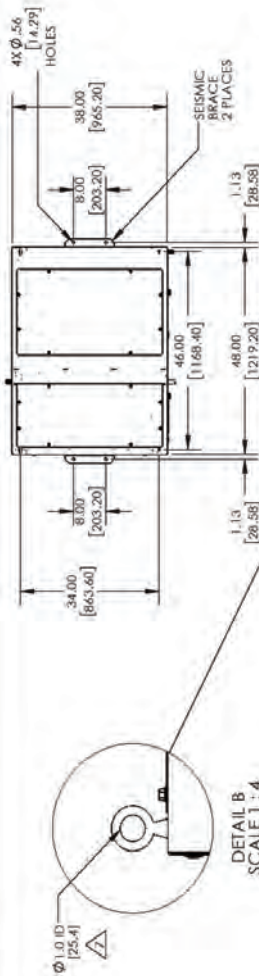


TITLE:

REACTOR W/BYPASS,FB,LH


SIZE	DWG. NO.	REV
B	92-15200001	X7
SCALE: NTS	SCALE: NTS	SHEET 1 OF 4

R/H SIDE VIEW
PANELS REMOVED


FRONT VIEW
WITH DOORS

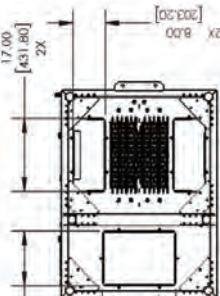

BOTTOM VIEW
REAR CABLE
ACCESS AREA

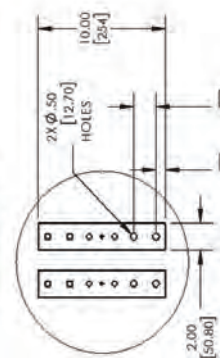

L/H SIDE VIEW
PANELS REMOVED

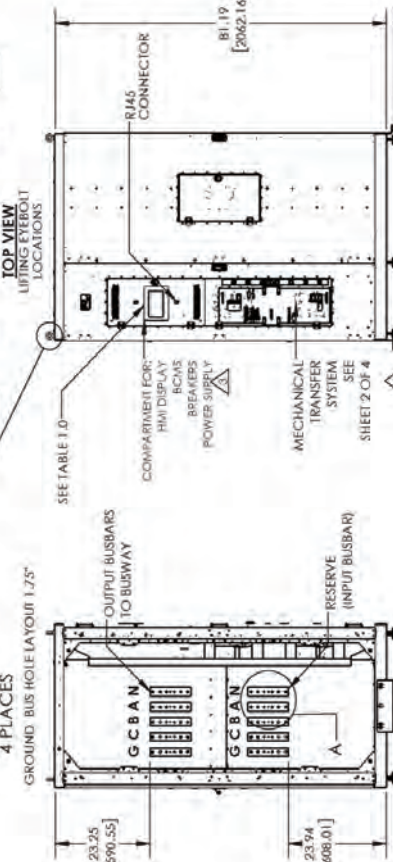

DETAIL A
SCALE: 1:8
TYPICAL